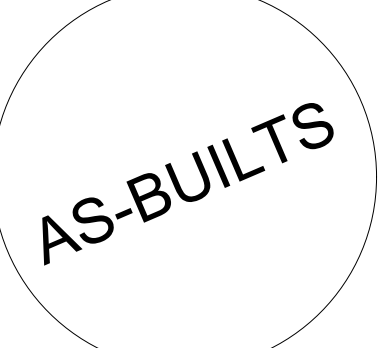


NORTH
 1 FLOOR PLAN
 A-110 1/4"=1'-0"


-4'-4"
GROUND

SQUARE FOOTAGE		
FIRST FLOOR		
CONDITIONED	1,786	SF
UNCONDITIONED		
FRONT PORCH	34	SF
TOTAL OF ALL SPACES	1,820	SF


 JODY BAKER 210.705.4101
 jody@alamoasbuilts.com AlamoAsBuilts.com
122 WEST AGARTIA AVE.
SAN ANTONIO, TX
 AS-BUILT FLOOR PLAN
 DATE: 08.21.2023


 Sheet Number
A-110

122 WEST AGARTIA AVE. - AS-BUILT DRAWINGS

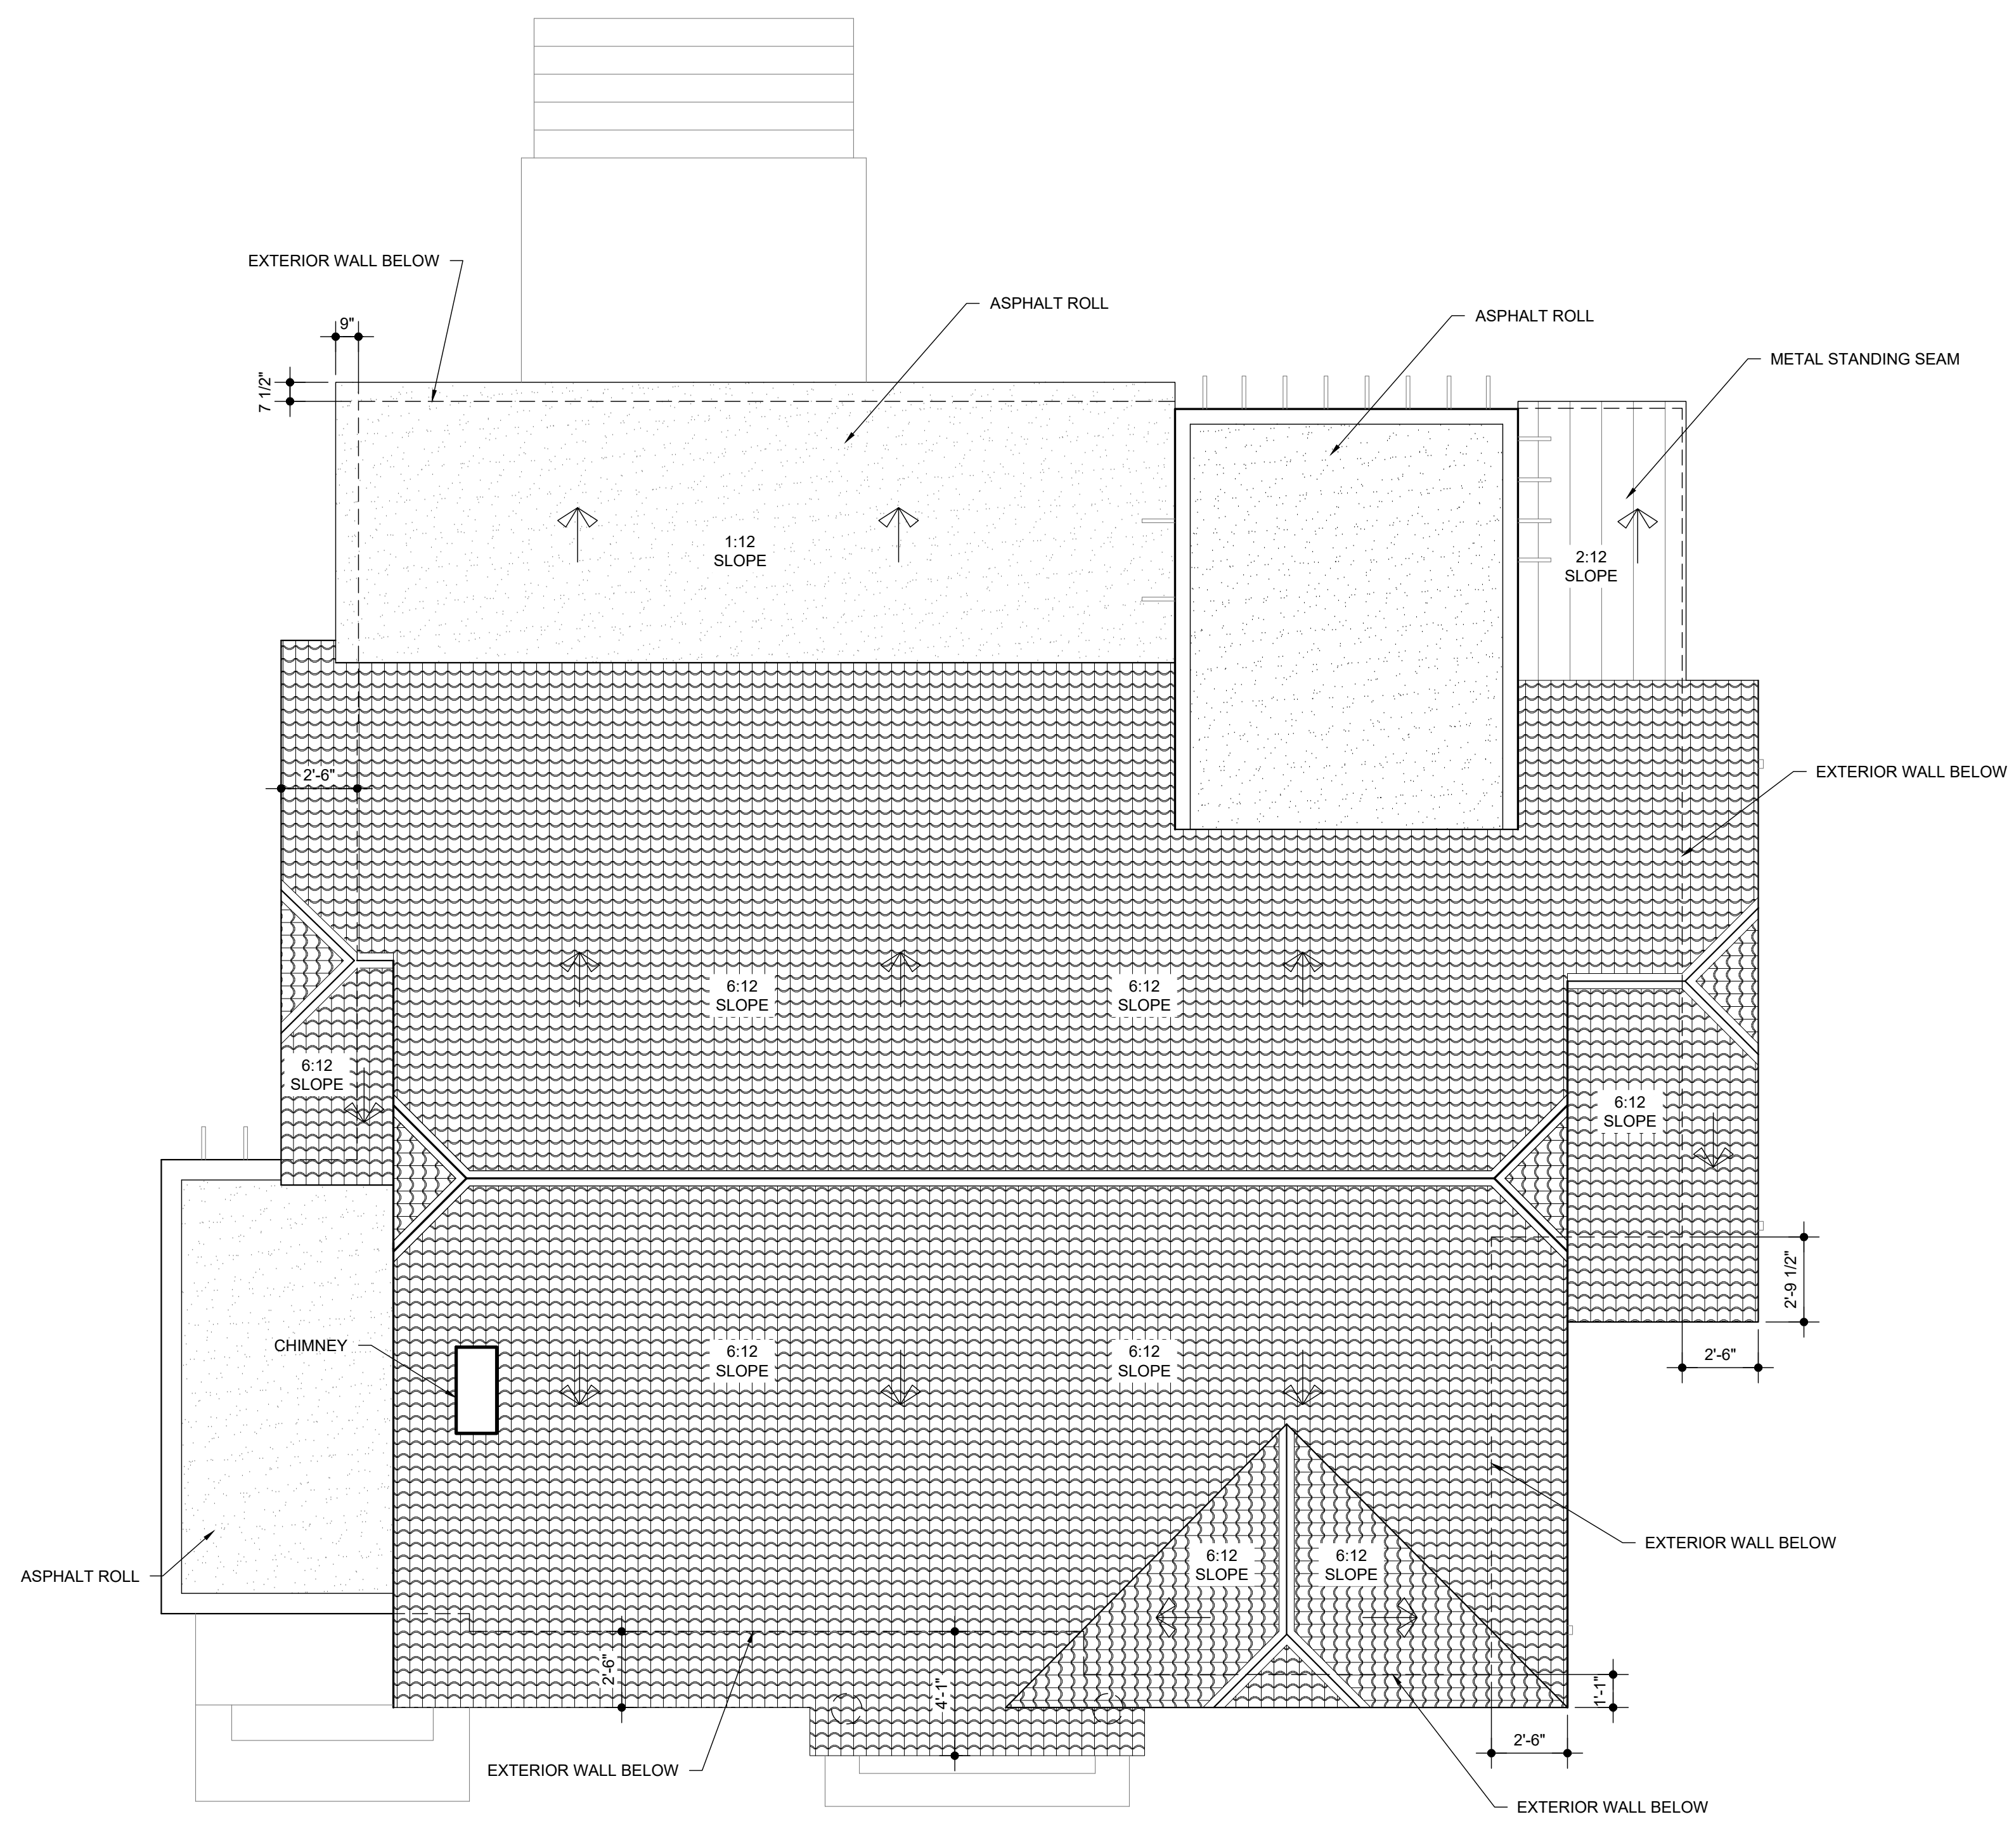

NORTH

1 ROOF PLAN
A-130
1/4"=1'-0"




JODY BAKER 210.705.4101
jody@alamoasbuilts.com AlamoAsBuilts.com


122 WEST AGARTIA AVE. SAN ANTONIO, TX	
AS-BUILT ROOF PLAN	
DATE: 08.21.2023	

AS-BUILTS

Sheet Number
A-130

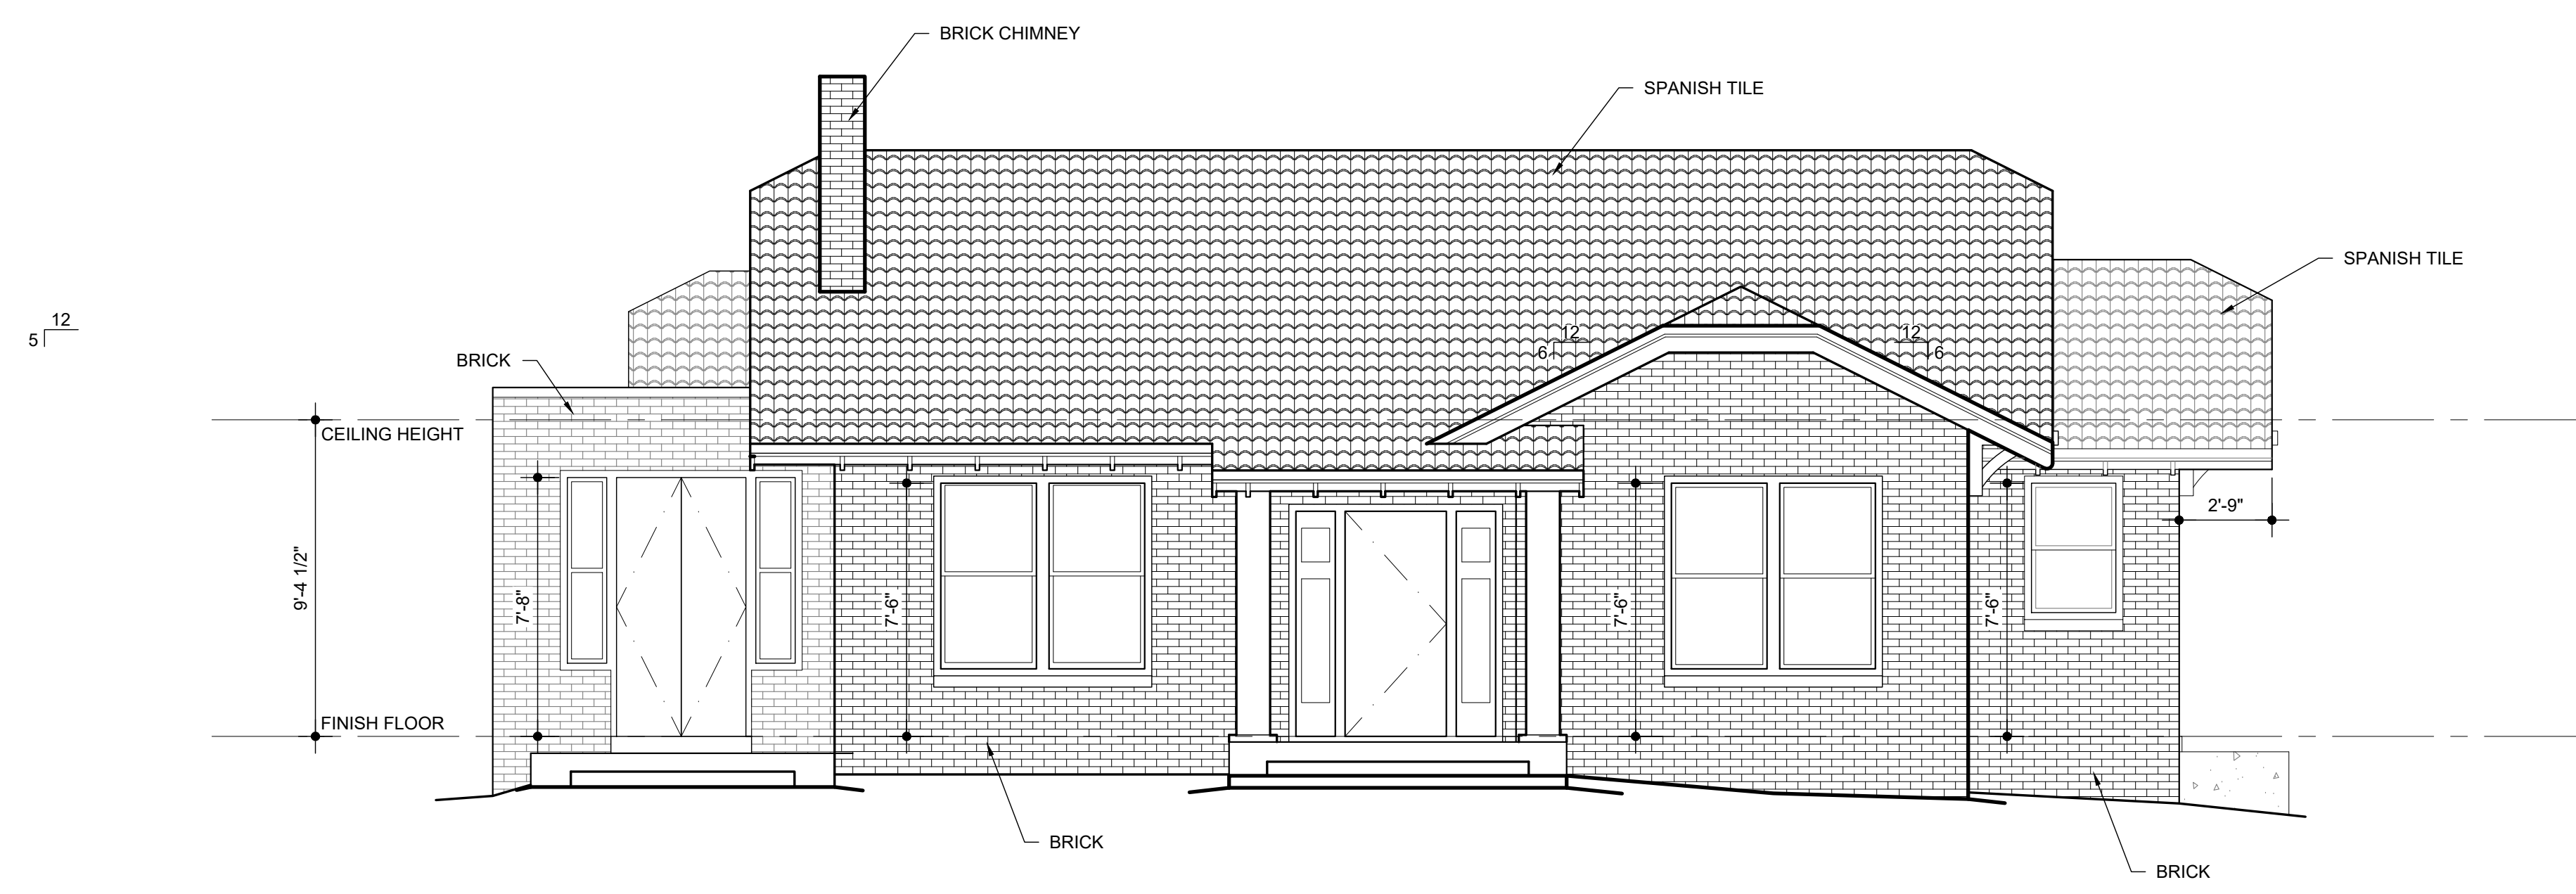

1 FRONT ELEVATION
A-200 1/4"=1'-0"

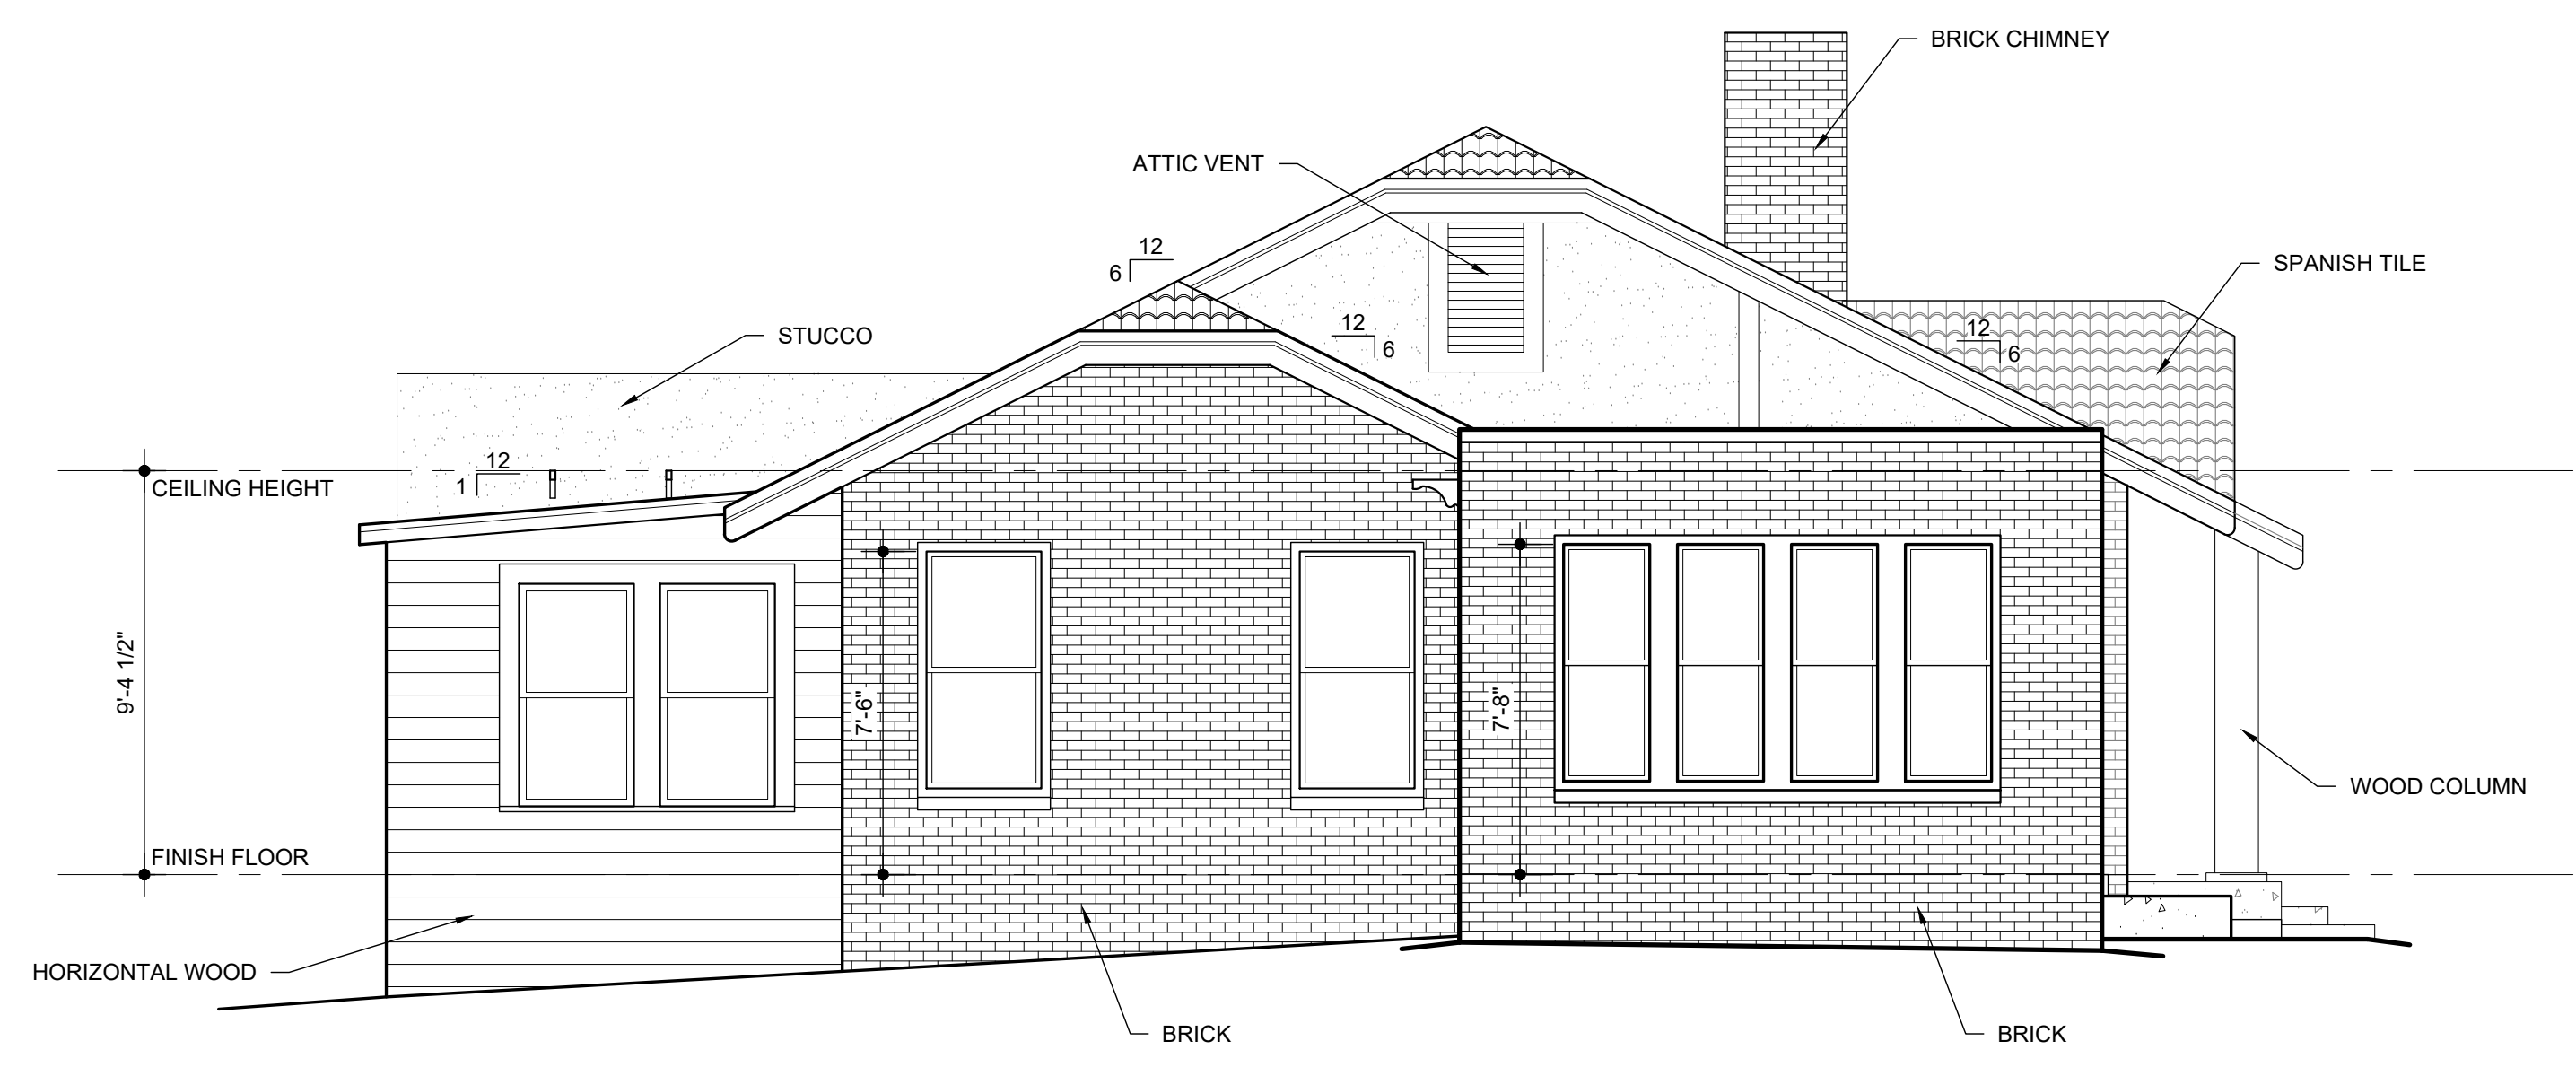

2 LEFT ELEVATION
A-200 1/4"=1'-0"




JODY BAKER 210.705.4101
jody@alamoasbuilts.com AlamoAsBuilts.com


122 WEST AGARTIA AVE.
SAN ANTONIO, TX

AS-BUILT ELEVATIONS


DATE: 08.21.2023

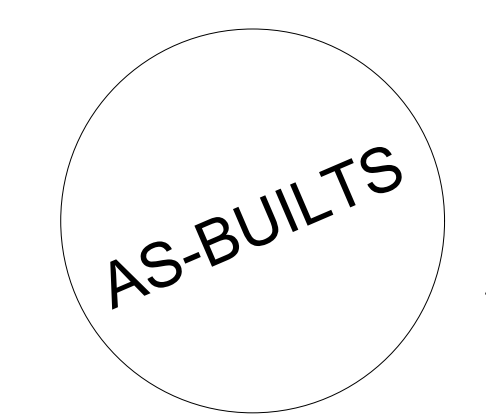


Sheet Number
A-200

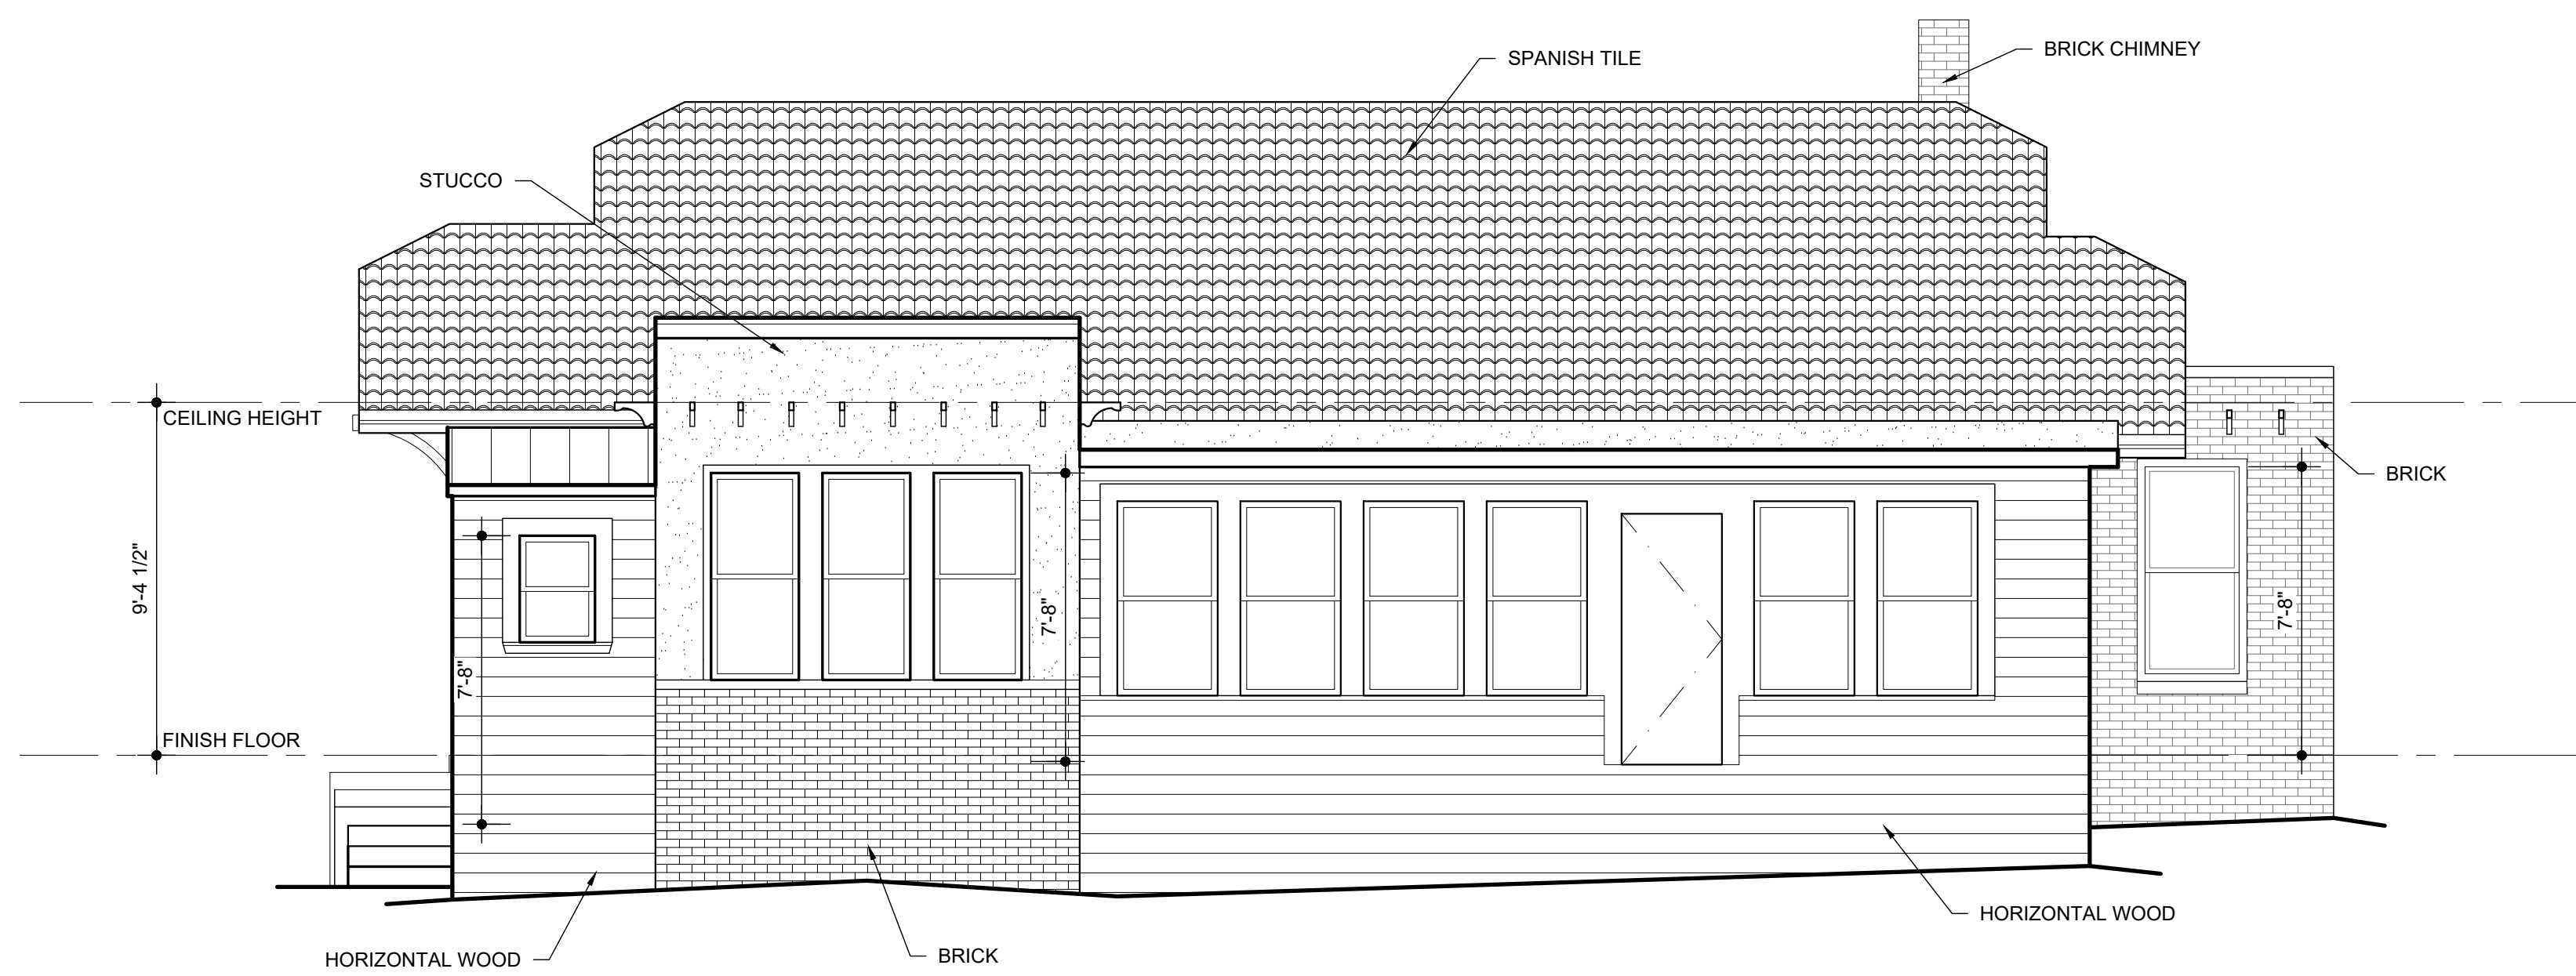

1 REAR ELEVATION
A-200 1/4"=1'-0"

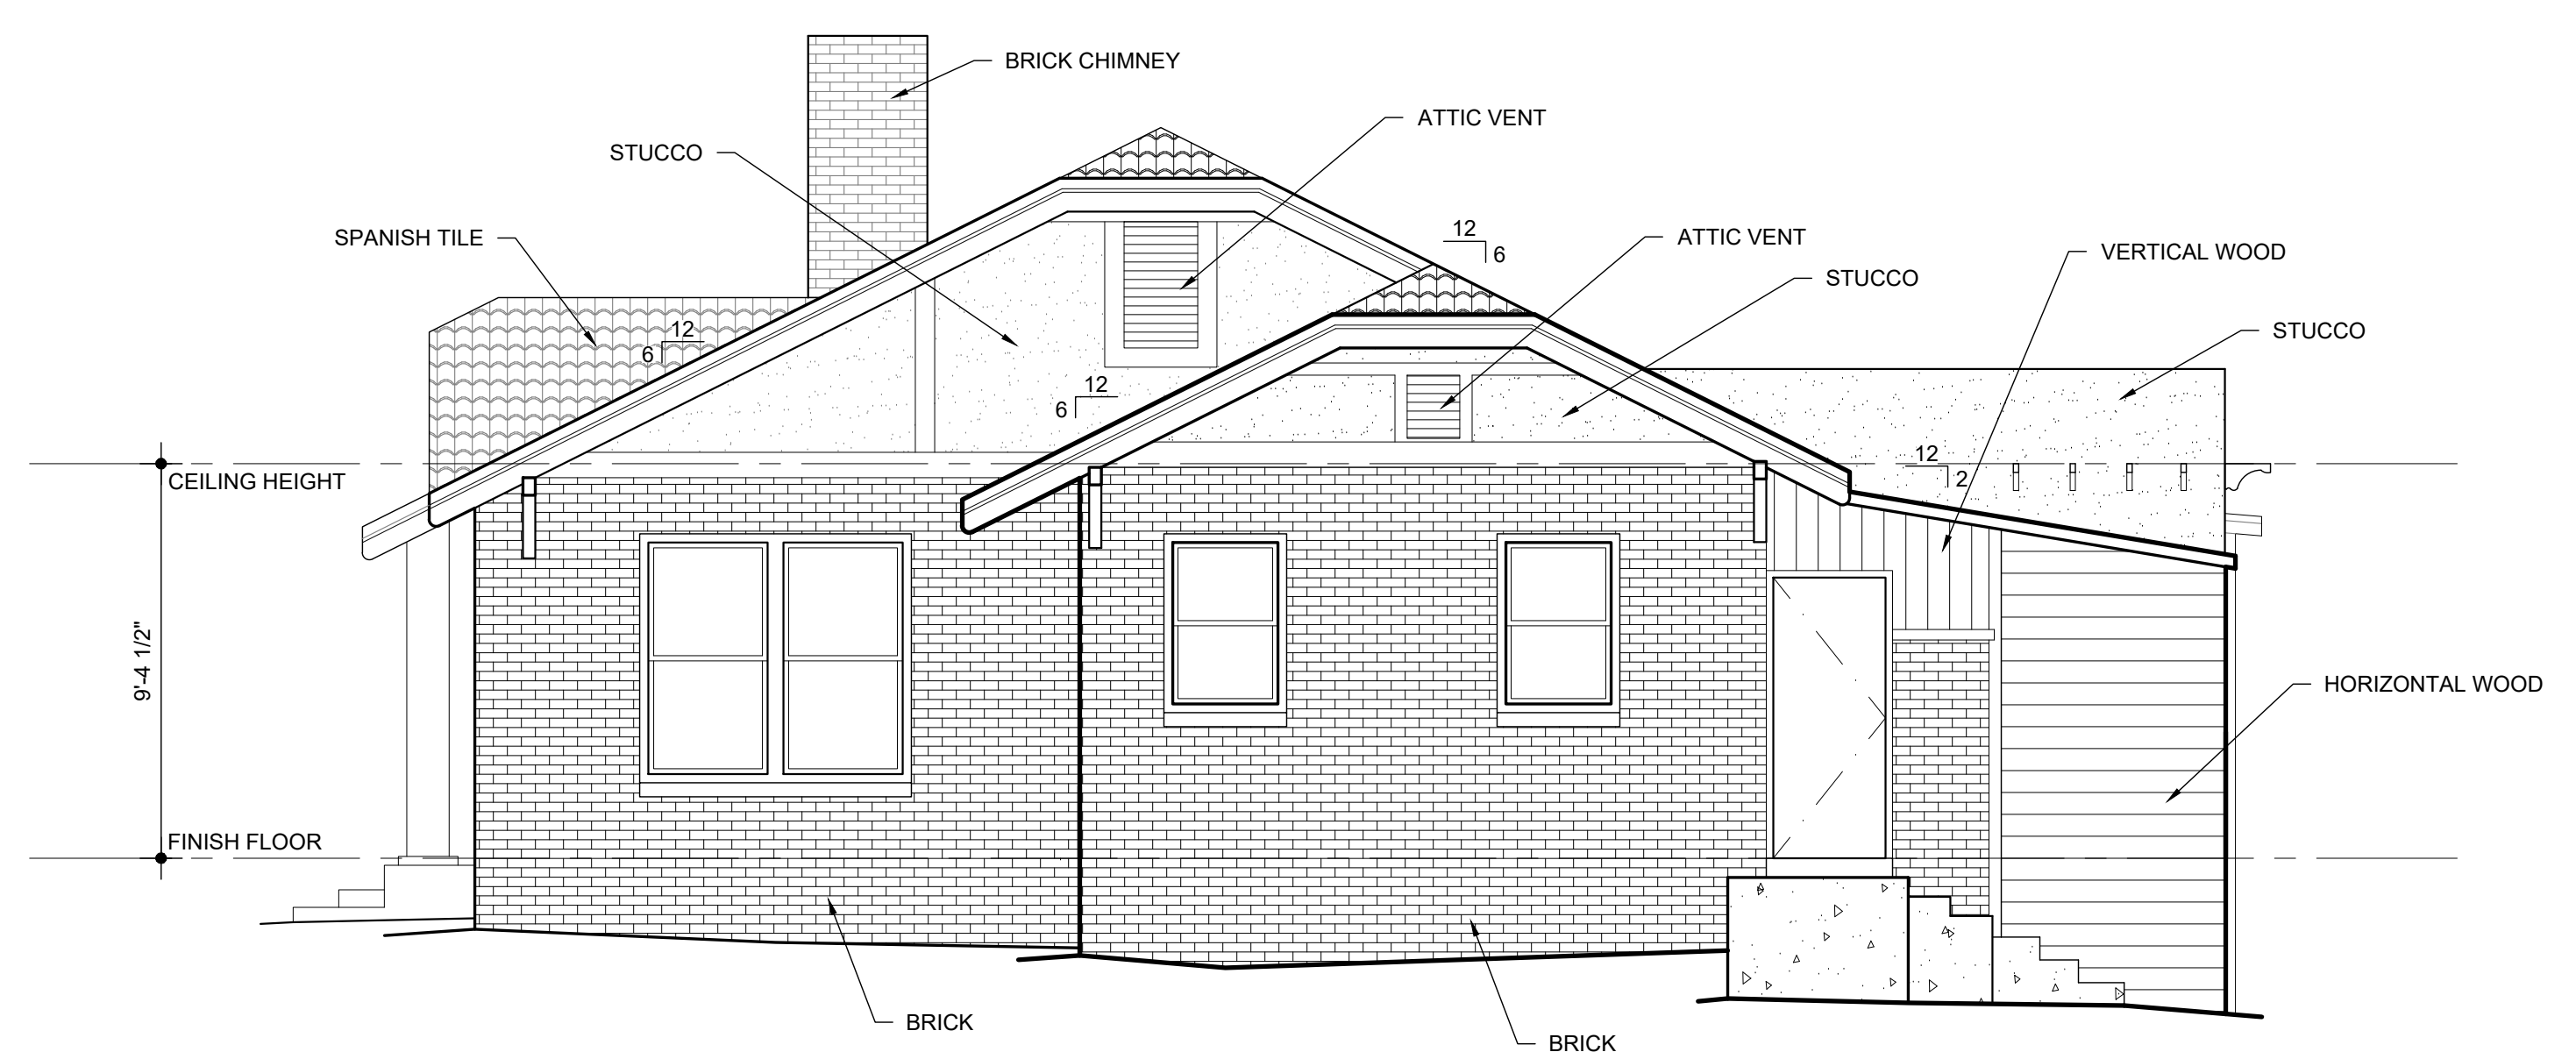

2 RIGHT ELEVATION
A-200 1/4"=1'-0"

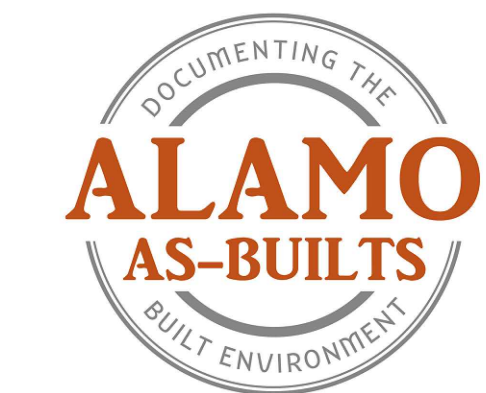


JODY BAKER 210.705.4101
jody@alamoasbuilts.com AlamoAsBuilts.com

122 WEST AGARTIA AVE.
SAN ANTONIO, TX

AS-BUILT ELEVATIONS

DATE: 08.21.2023

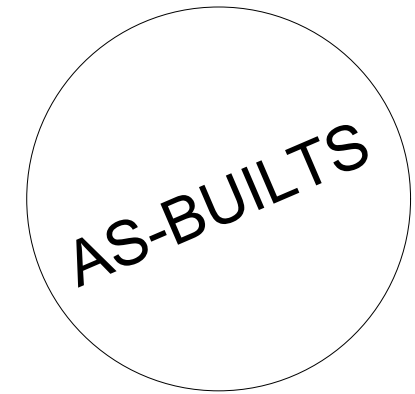

Sheet Number

A-201